


- Elektrisk ledning
- Repareringsledning
- Signaltilførsel
- Vekselledning
- ..... Telekabel



Jakob Melin 051208


Skinnersdal  
Relationsritning  
"Norra byn"

1 1:500

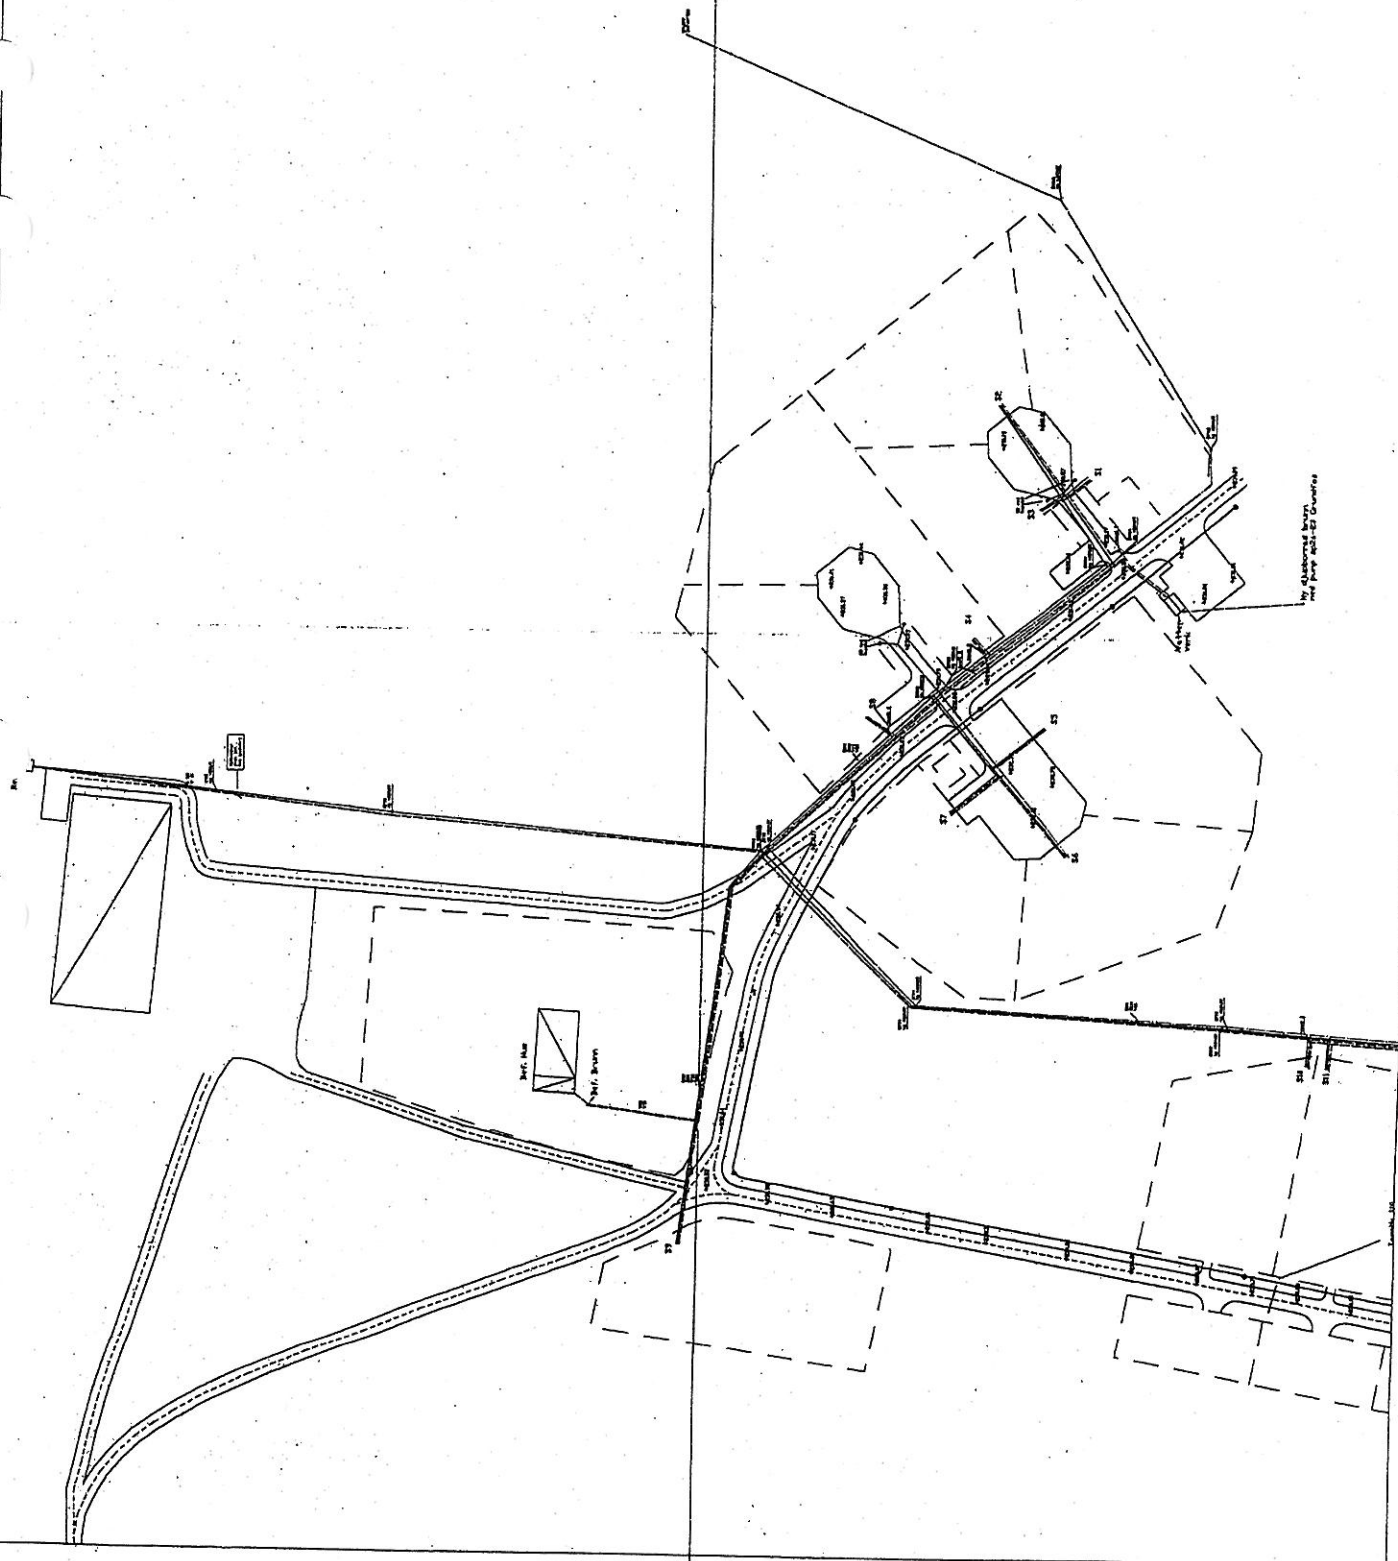

- Dashed boundary
- Boundary
- Administrative boundary
- Watercourse
- Railway


By Afdelingschefen  
for pump station 22

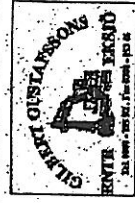


Jakob Melin 051208

Skinnersdal  
Relationsritning  
'Mellanbyn'

2 1:500

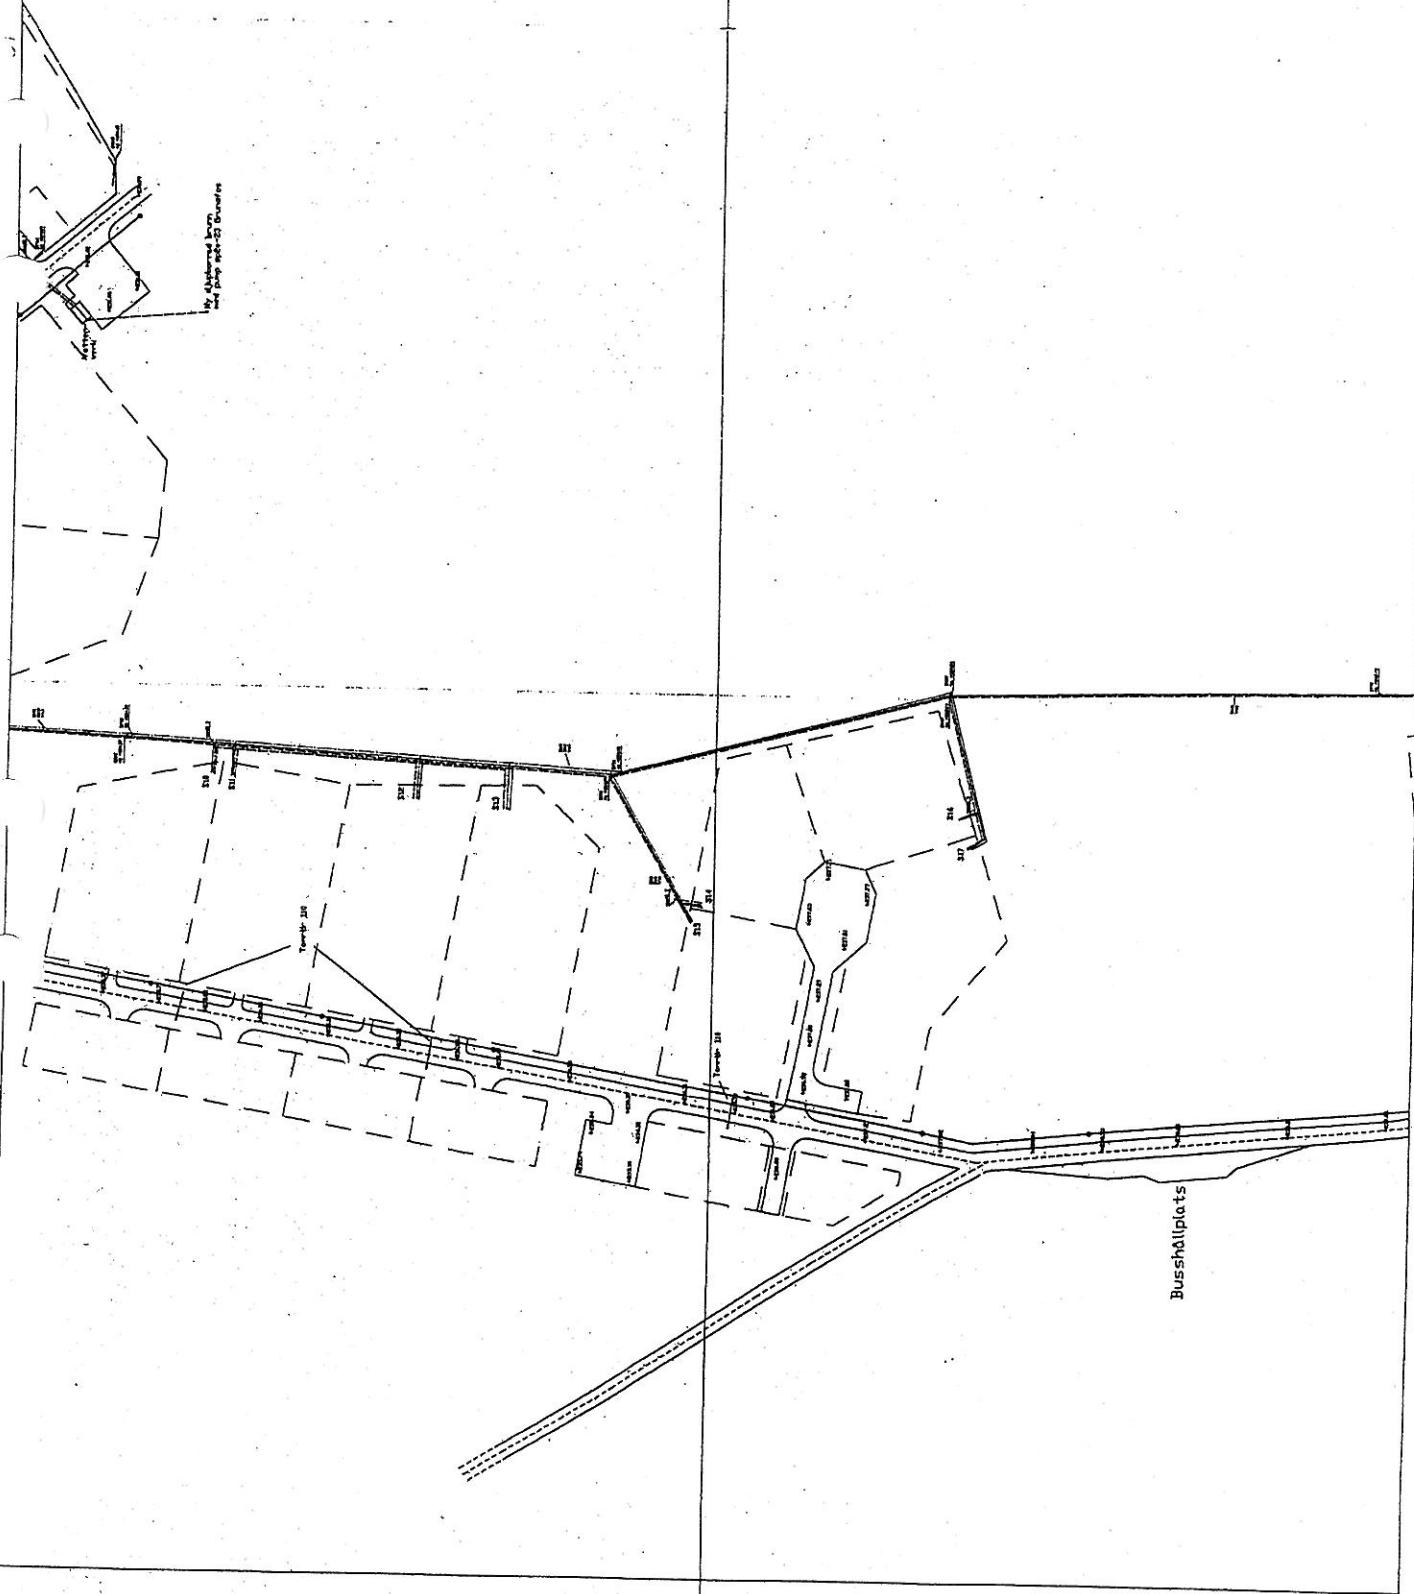

- Guldin belysning
- Ragnvannledning
- Sirkulærledning
- VA-tilførsling
- Polypropylenrør

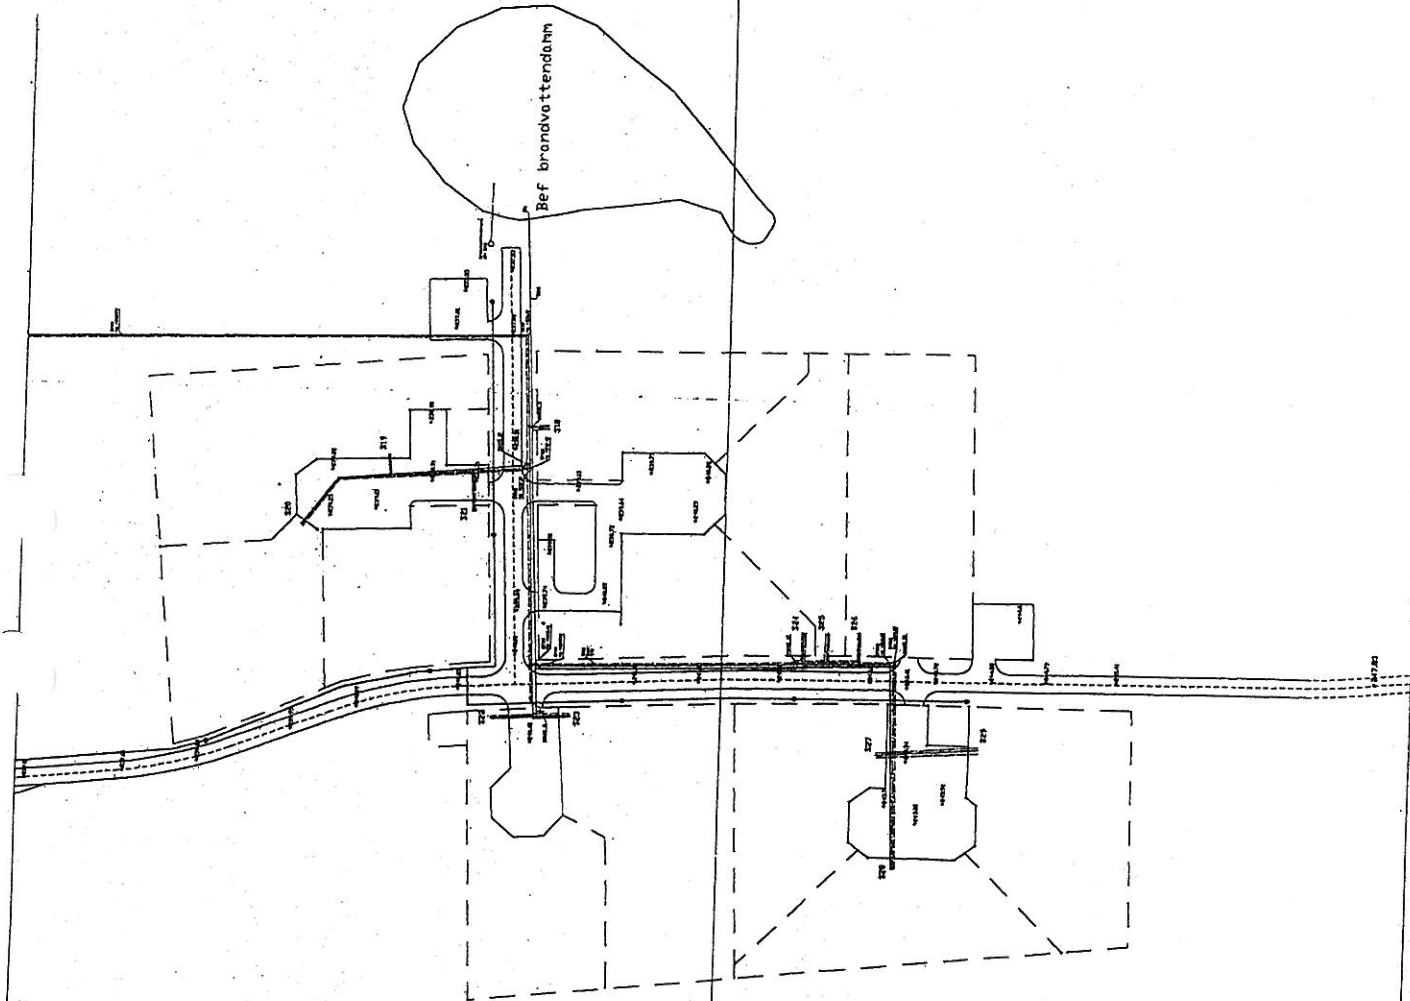

Prosjekt nr. Jakob Melin 051208	
Skinnerdal Relasjonsritning 'Sbera byn'	
3	1:500